


INTEGRUS ARCHITECTURE
 10 SOUTH CEDAR STREET
 SPOKANE WASHINGTON 99204
 509.838.8881 FAX 509.838.7194

LMNARCHITECTS
 801 SECOND AVENUE SUITE 501
 SEATTLE WASHINGTON 98104
 206.682.3460 FAX 343.5388

CONSTRUCTION SET
 (REVISED - BID PACKAGE 6)

SPOKANE CONVENTION CENTER EXPANSION

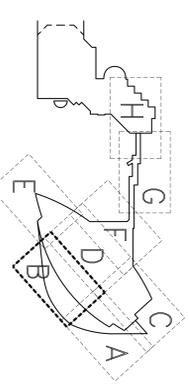


REVISIONS

NO.	DATE	BY	REVISION
1	10-20-04	BR-1	ADDITIONAL #1
2	10-28-04	BR-1	ADDITIONAL #2
3	11-04-04	BR-1	ADDITIONAL #3
4	01-21-05	BR-1	CLARIFICATION DWG
5	3-07-05	BR-2	
6	4-15-05	CDI	025

DESIGNED	DRAWN	CHECKED	DATE
F.A./H	JDC	JDC	4-15-05

CDI FILE: 150a_1-01B.dwg
 JOB NUMBER: 20150100

TITLE
**PARKING LEVEL 01
 FOUNDATION
 SECTOR B**
S1.1B

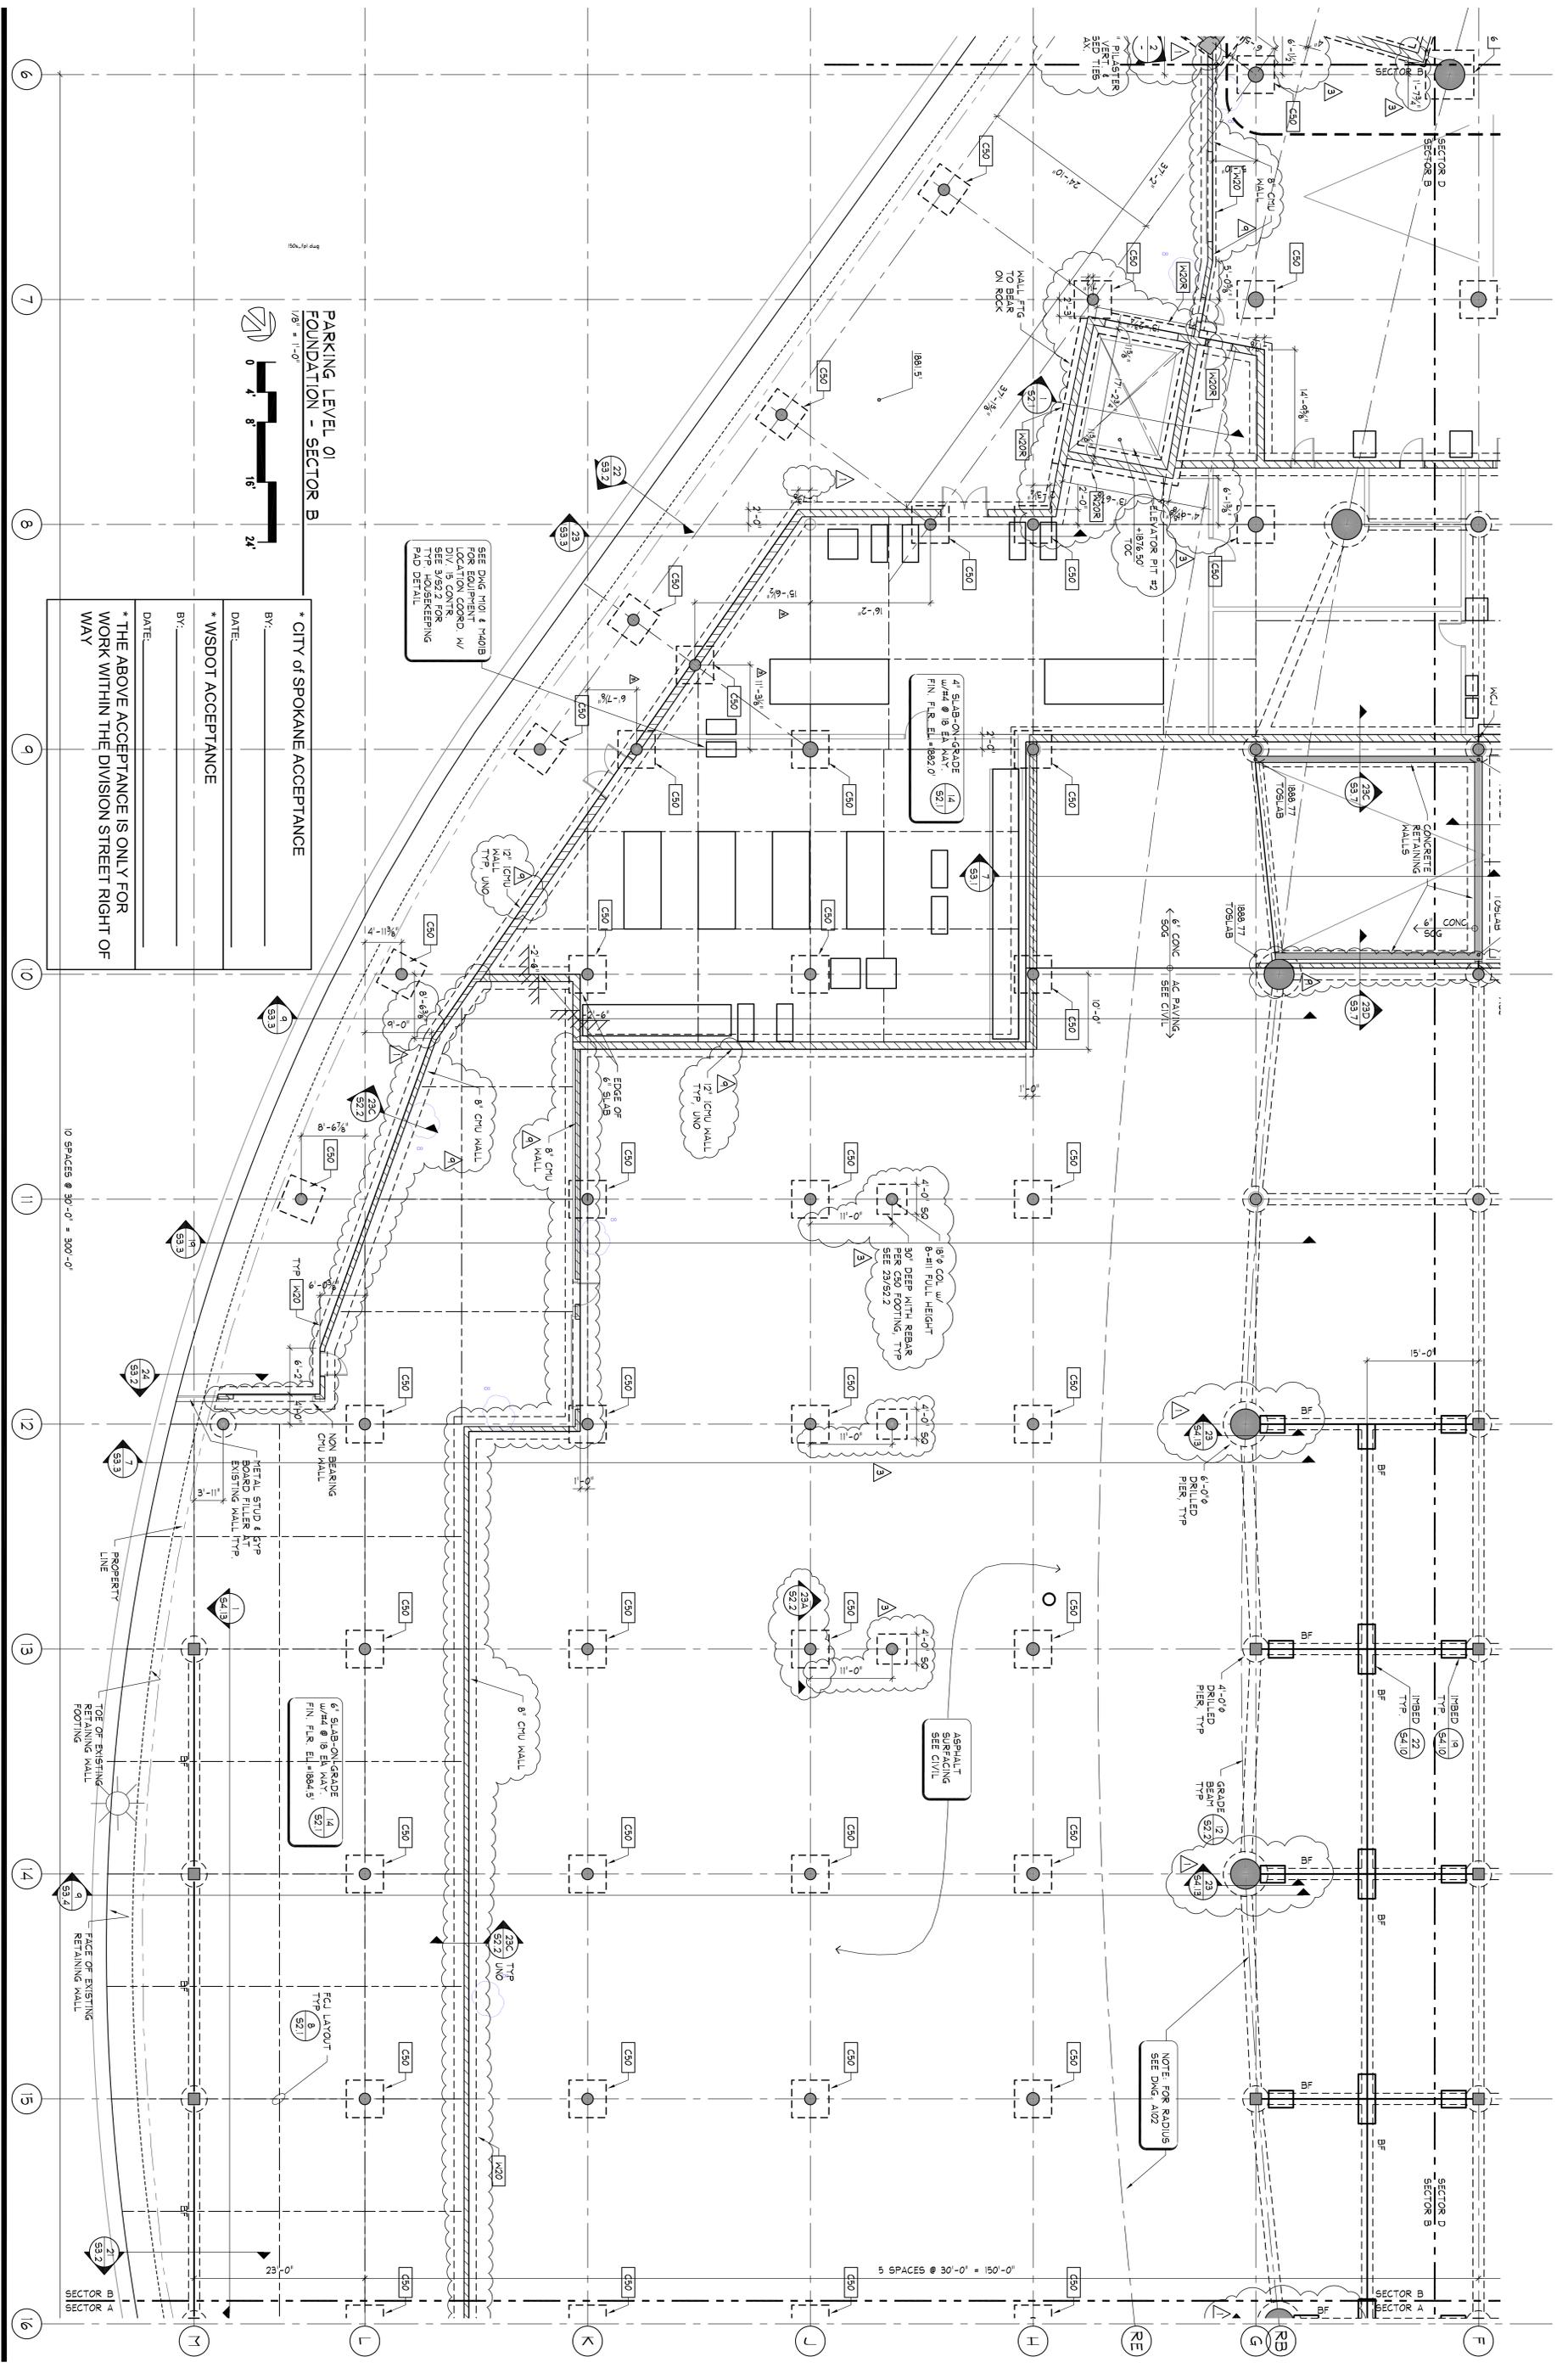

**PARKING LEVEL 01
 FOUNDATION - SECTOR B**
 1/8" = 1'-0"

0 4' 8' 16' 24'

* CITY OF SPOKANE ACCEPTANCE
 BY: _____
 DATE: _____

* WSDOT ACCEPTANCE
 BY: _____
 DATE: _____

* THE ABOVE ACCEPTANCE IS ONLY FOR WORK WITHIN THE DIVISION STREET RIGHT OF WAY

SEE DWG 150A_1401B FOR EMBLEMMENT LOCATION COORD. W/ DIV. 15 CONTR. SEE 3/05/02 FOR P.D. DETAILED

ASPHALT SURFACING SEE CIVIL

NOTE FOR RADIUS SEE DWG. A102

10 SPACES @ 30'-0" = 300'-0"

5 SPACES @ 30'-0" = 150'-0"