


**INTEGRUS ARCHITECTURE**  
 10 SOUTH CEDAR STREET  
 SPOKANE WASHINGTON 99204  
 509.838.8881 FAX 838.2194  
**LMNARCHITECTS**  
 801 SECOND AVENUE SUITE 501  
 SEATTLE WASHINGTON 98104  
 206.682.3460 FAX 343.5388

**CONSTRUCTION SET**  
 (REVISED - BID PACKAGE 6)

**SPOKANE CONVENTION CENTER EXPANSION**

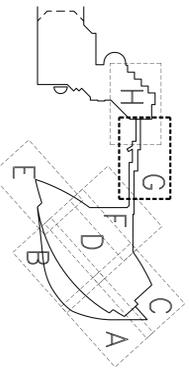


REVISIONS

NO.	DATE	BY	DESCRIPTION
1	10-20-04		BP-1 ADDENDUM #1
2	10-28-04		BP-1 ADDENDUM #2
3	11-04-04		BP-1 ADDENDUM #3
4	01-21-05		BP-1 CLARIFICATION DWG
5	3-07-05		BP-2
6	4-15-05		CD 025

DESIGNED	DATE
150_qr46	150_qr46.dwg
20150100	20150100

TITLE  
**PARKING LEVEL 01  
 FOUNDATION - SECTOR G**  
**S1.1G**

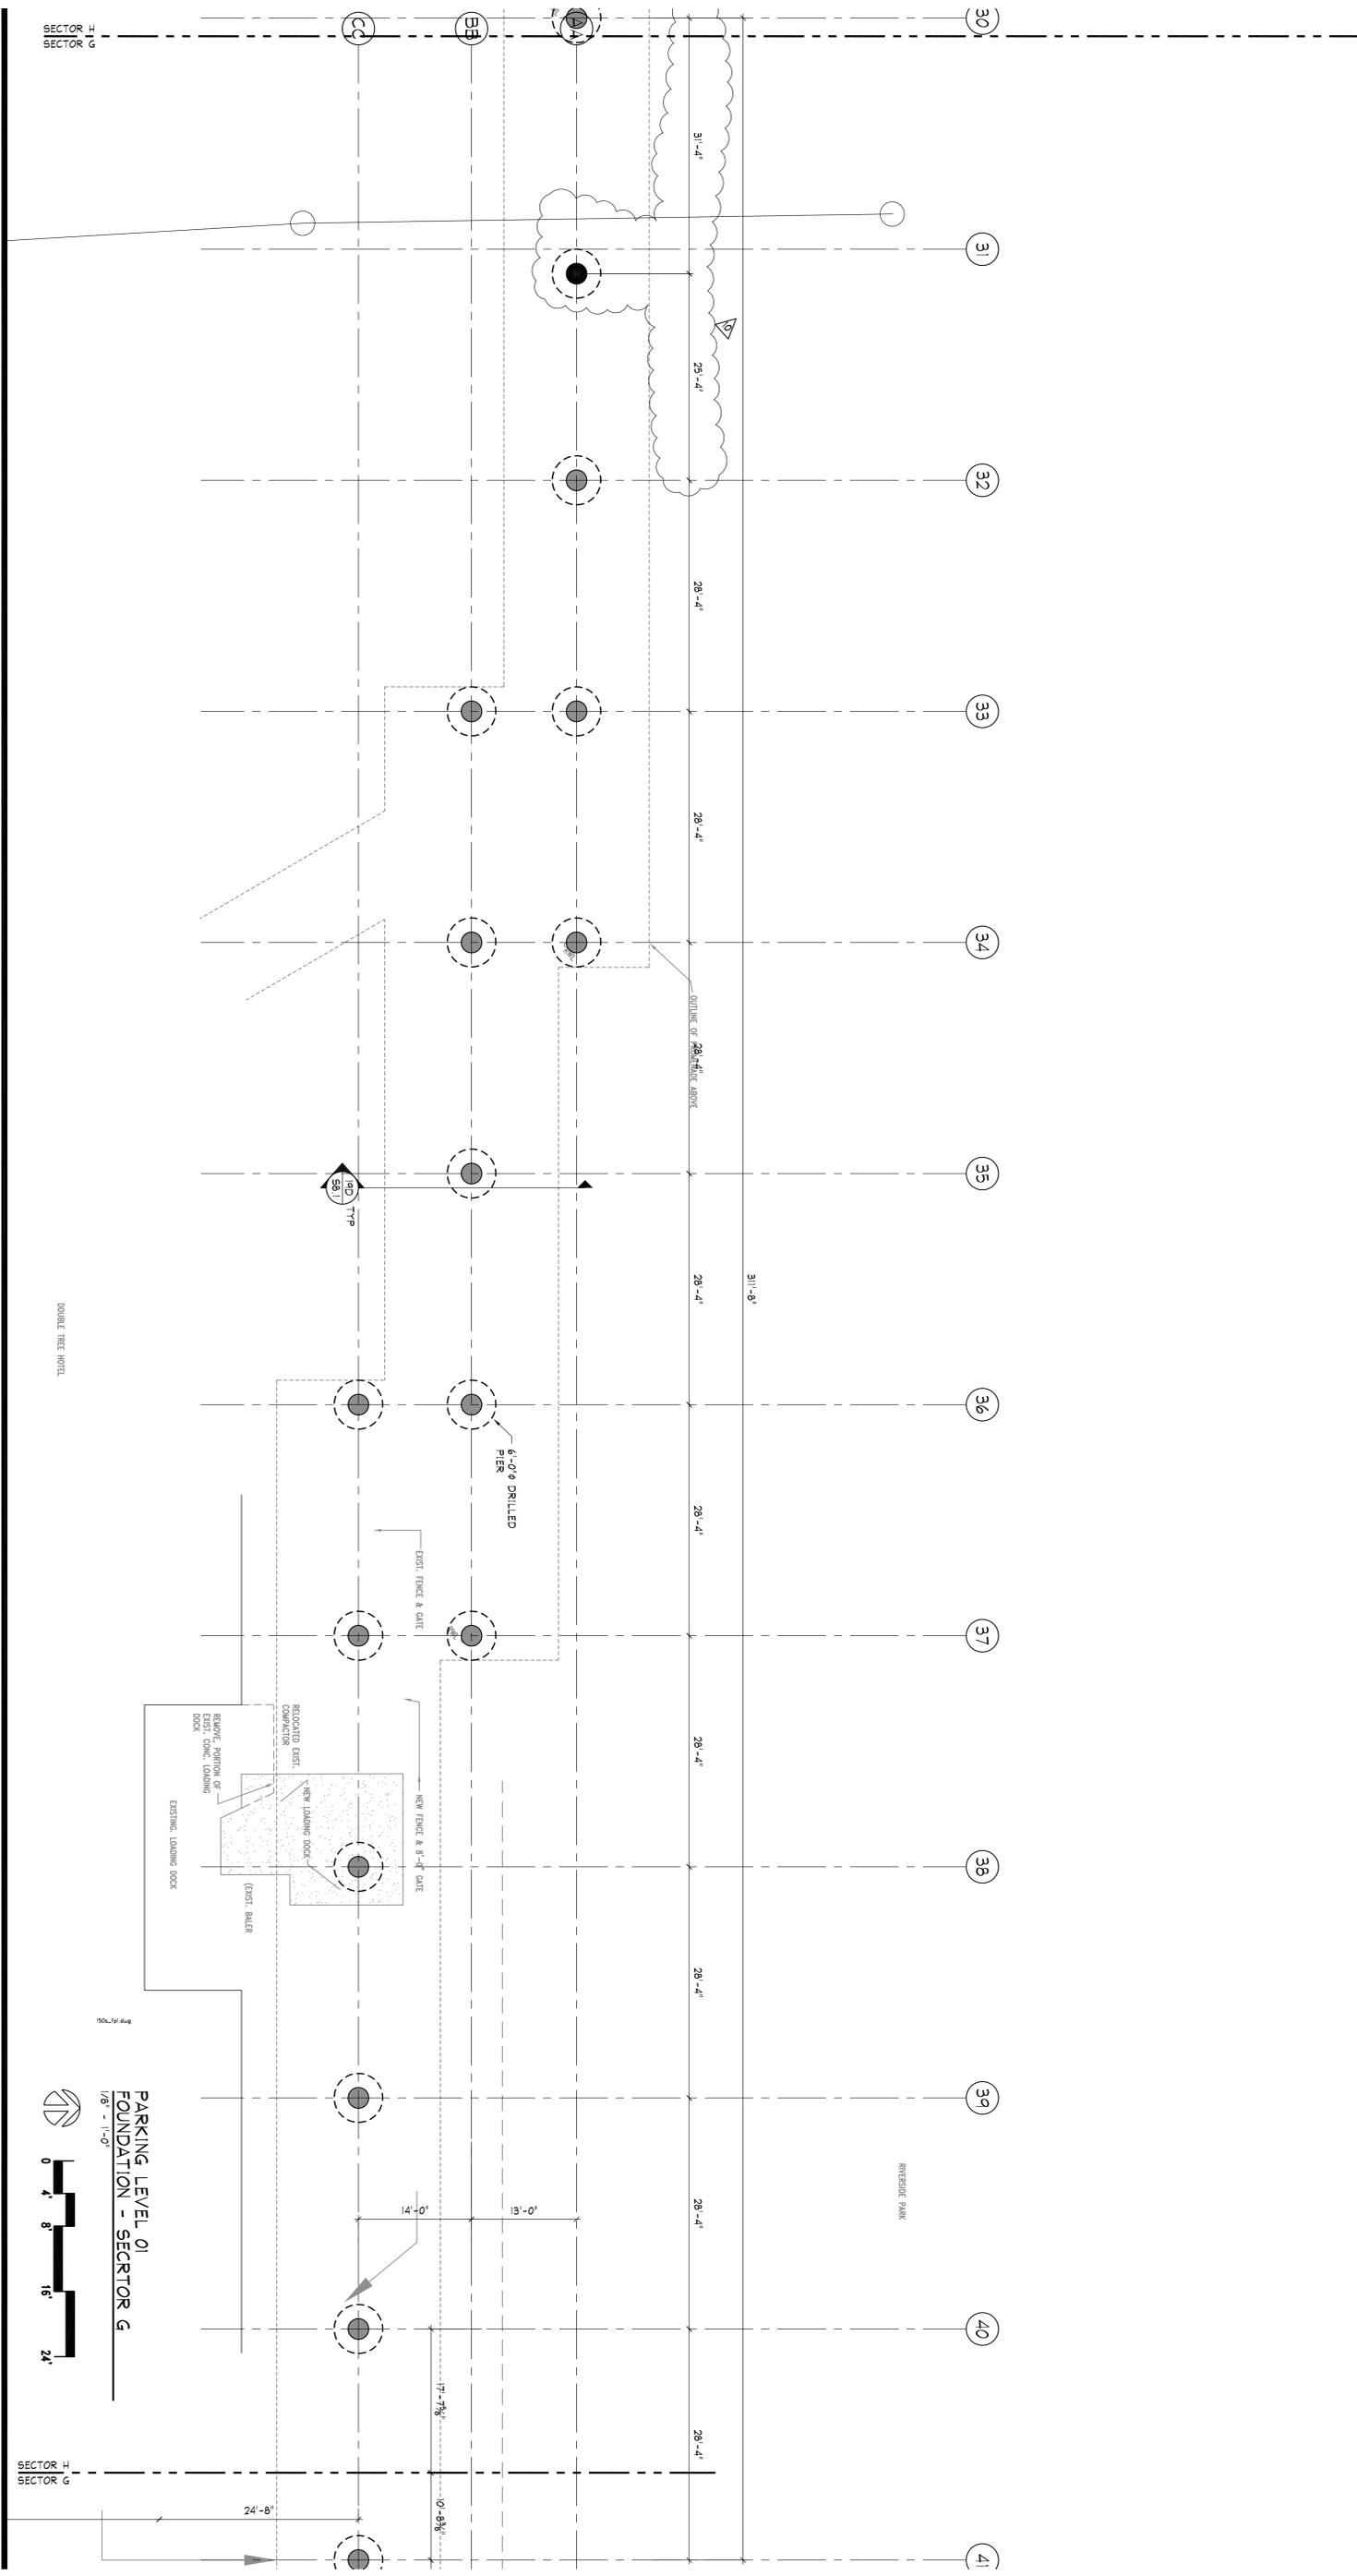

SECTOR H  
 SECTOR G