


INTEGRUS ARCHITECTURE
 10 SOUTH CEDAR STREET
 SPOKANE WASHINGTON 99204
 509.838.8881 FAX 509.838.2194
LMN ARCHITECTS
 801 SECOND AVENUE SUITE 501
 SEATTLE WASHINGTON 98104
 206.682.3460 FAX 343.5388

CONSTRUCTION SET
 (REVISED - BID PACKAGE 6)

SPOKANE CONVENTION CENTER EXPANSION

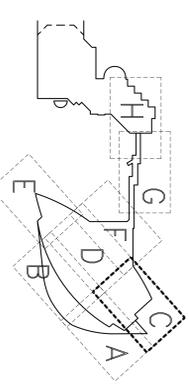

REVISIONS

NO.	DATE	BY	DESCRIPTION
1	10-20-04	BR-1	ADDITIONAL #1
2	10-28-04	BR-1	ADDITIONAL #2
3	11-04-04	BR-1	ADDITIONAL #3
4	01-21-05	BR-1	CLARIFICATION DWG
5	3-07-05	BR-2	
6	4-15-05	CDI	025

DESIGNED	DATE
150a_1-01.dwg	20150100

PARKING LEVEL 01 FOUNDATION - SECTOR C
 SCALE: 1/8" = 1'-0"
 TITLE: PARKING LEVEL 01 FOUNDATION SECTOR C
S1.1C