



LMN ARCHITECTS

10 SOUTH CEDAR STREET

SPOKANE WASHINGTON 99204  
509.838.8681 FAX 838.2194

509.838.8681 FAX 838.2194


ARCHITECTS

801 SECOND AVENUE SUITE 50

206.682.3460 FAX 343.9388

(REVISED--BID PACKAGE 6)

**SPOKANE  
CONVENTION CENTER  
EXPANSION**

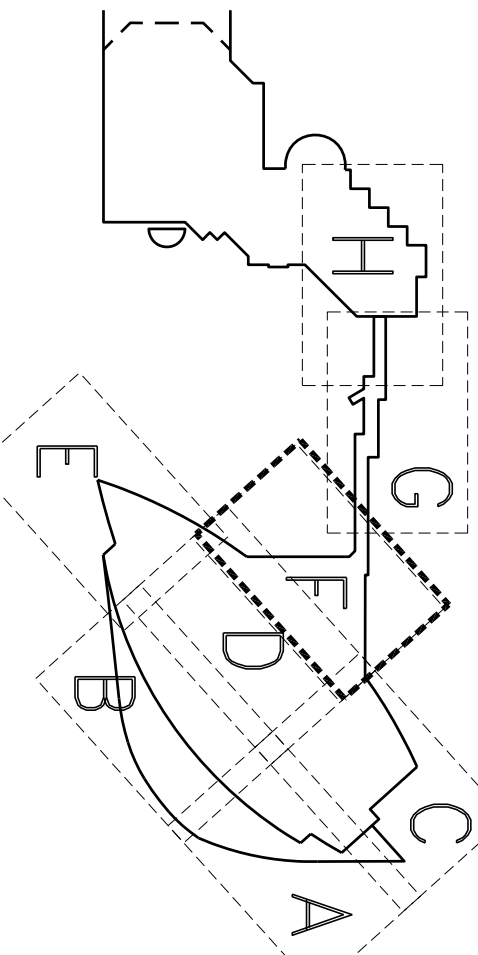

NO.	DATE	BY	DESCRIPTION
5	10-20-04		BP-4- ADDENDUM #1
6	10-28-04		BP-4- ADDENDUM #2
7	11-04-04		BP-4- ADDENDUM #3
8			BP-4- CLARIFICATION
9	01-21-05		BP-5
10	3-07-05		BP-6
11	4-15-05		COD 025

DESIGNED	
DRAWN	MA/HH
CHECKED	JDC
DATE	4-15-05
CADD FILE	150a_1-01F.dwg
JOB NUMBER	20150.00

FILE

PARKING LEVEL 01


FOUNDATION

## SECTOR

2

**C**

## § 1.1F

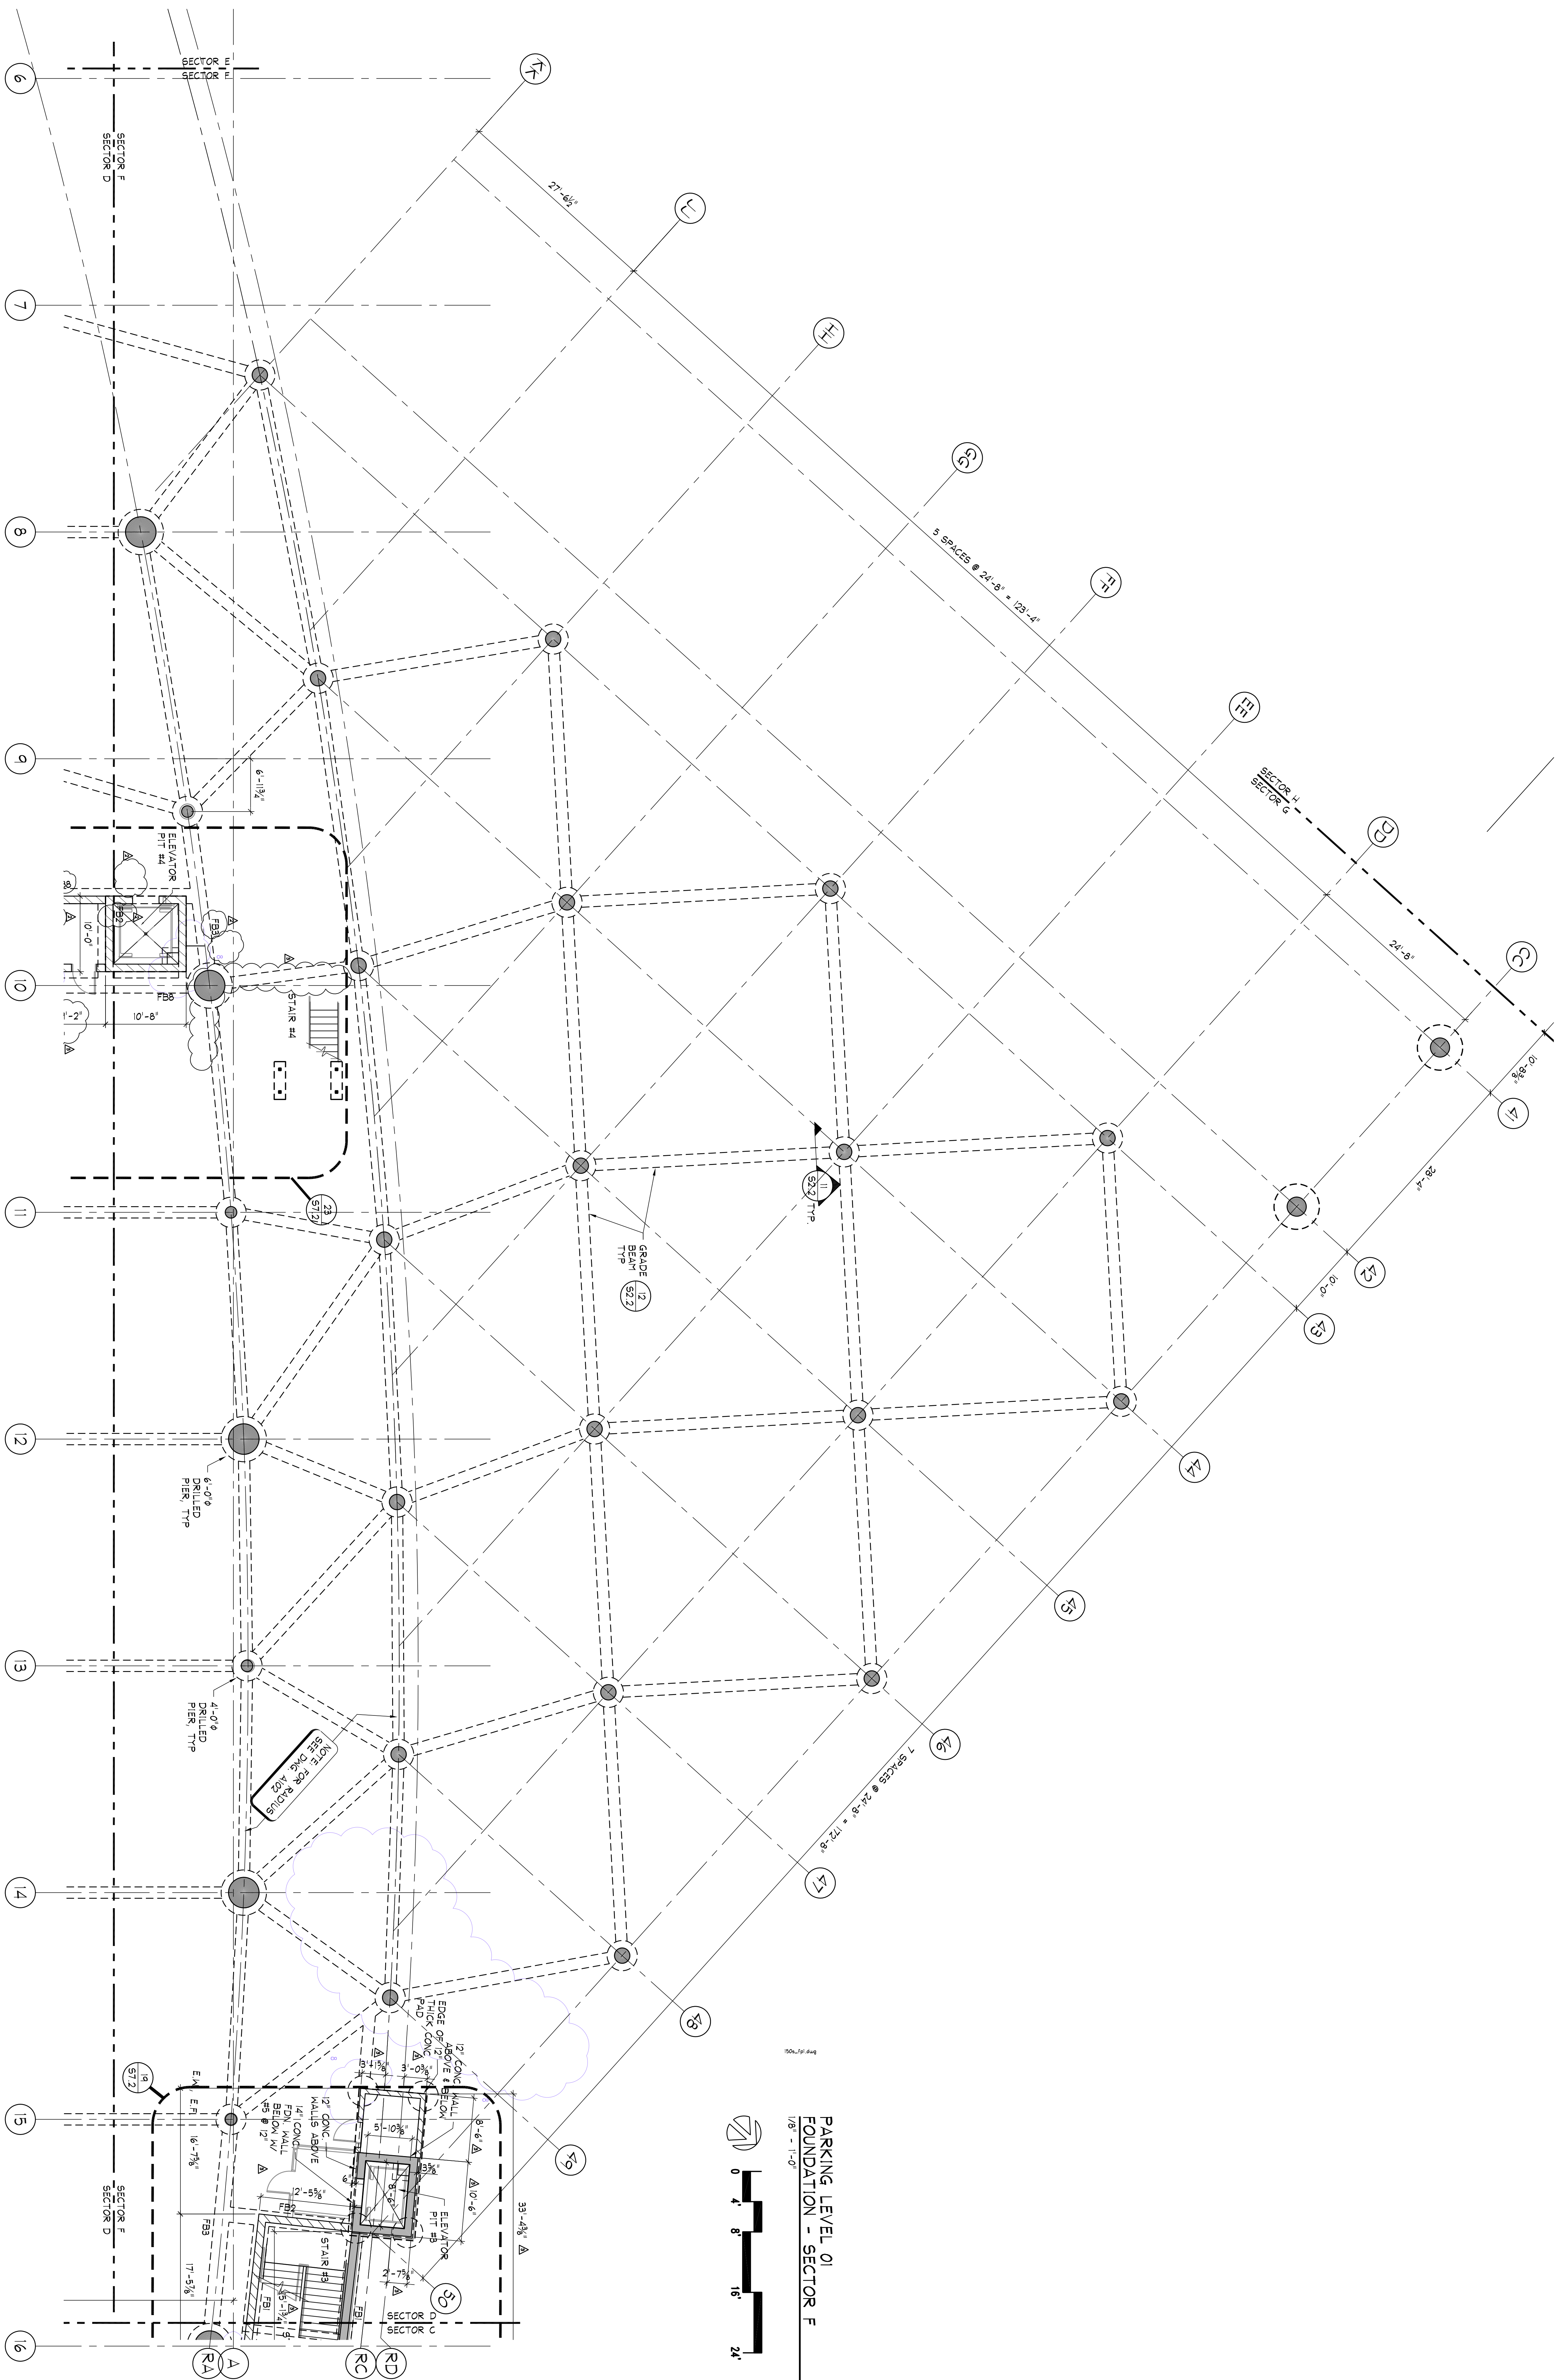

**PARKING LEVEL 01**  
**FOUNDATION - SECTOR F**

1/8" - 1" - 8/1

