


AT THIS LEVEL, BFD WORK INCLUDES:
 * SCREENWALL COLUMNS AND BASE
 * STAIRS AND LANDINGS
 * BRACE FRAME STEEL (NOT FIBERS)
 * VEHICLE RESTRAINT
 * LIGHT GAUGE FRAMING


PARKING LEVEL 01M - FRAMING
 1/32" = 1'-0"

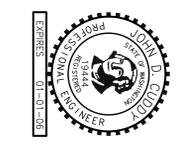

INTEGRUS ARCHITECTURE
 10 SOUTH CEDAR STREET
 SPOKANE WASHINGTON 99204
 509.838.8881 FAX 509.838.2194
LMN ARCHITECTS
 801 SECOND AVENUE SUITE 501
 SEATTLE WASHINGTON 98104
 206.682.3460 FAX 343.5388

CONSTRUCTION SET
 (REVISED - BID PACKAGE 6)

SPOKANE CONVENTION CENTER EXPANSION

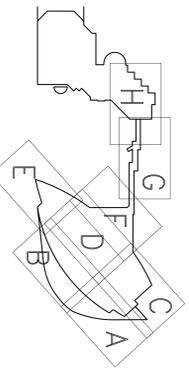

REVISIONS

NO.	DATE	BY	DESCRIPTION
1	10-20-04		BR-1 ADDENDUM #1
2	10-28-04		BR-1 ADDENDUM #2
3	11-04-04		BR-1 ADDENDUM #3
4	01-21-05		BR-1 CLARIFICATION DWG
5	3-07-05		BR-2
6	4-15-05		CDI 025

DESIGNED	DATE
BRANN	11/4/04
CHECKED	JDC
DATE	4-15-05
GRID FILE	150a_1-02.dwg
JOB NUMBER	20150100

TITLE
PARKING LEVEL 01M FRAMING
S1.2