


INTÉGRUS ARCHITECTURE
10 SOUTH CEDAR STREET
SPOKANE, WASHINGTON 99204
509.838.8881 FAX 838.2194
LMNARCHITECTS
801 SECOND AVENUE, SUITE 501
SEATTLE, WASHINGTON 98104
206.882.3460 FAX 343.5388

CONSTRUCTION SET
(REVISED—BID PACKAGE 6)

SPOKANE
CONVENTION CENTER
EXPANSION

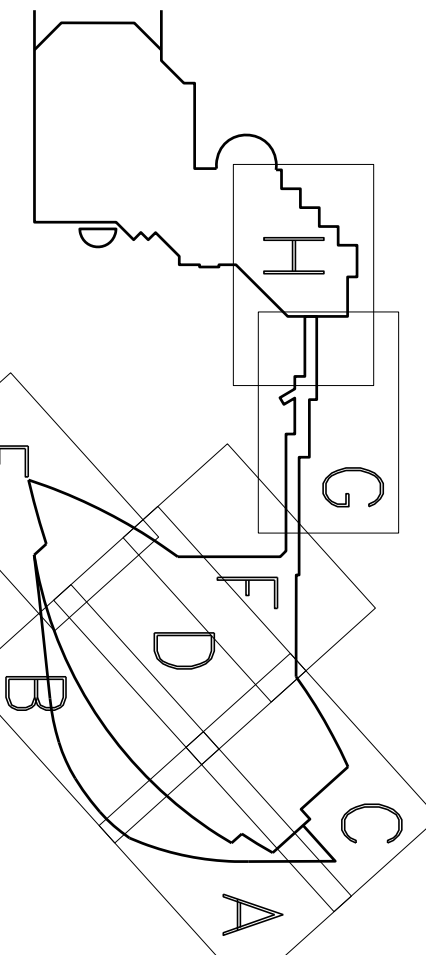

NO.	DATE	BY	DESCRIPTION
1	10-20-04	BR-1	ADDENDUM #1
2	10-28-04	BR-1	ADDENDUM #2
3	11-04-04	BR-1	ADDENDUM #3
4	01-21-05	BR-1	CLARIFICATION DWG
5	3-07-05	BR-6	
6	4-15-05	CDI 025	

DESIGNED	DATE
BR-1	10-20-04
CHECKED	JDC
DATE	4-15-05
GRID FILE	150a_fpk.dwg
JOB NUMBER	20150100




KEY:

- 1870— = CONTOUR FOR TOP OF COMPETENT BEDROCK BASED ON NAVD83 DATUM
- B-201 = BOREHOLES PER GEOTECH REPORT BY GEO ENGINEERS DATED 9-25-2002
- 1882— = CONTOUR FOR FINISHED GRADE
- 1881--- = EXISTING GRADE
- = PIER ON COMPETENT ROCK
- = FOOTING ON COMPETENT ROCK
- ==== = STRIP FOOTING ON COMPETENT ROCK
- = TOP 1'-4" BELOW FINISHED GRADE

ROCK CONTOURS ARE SHOWN FOR BIDDING PURPOSES ONLY
LENGTH OF PIER CALCULATION
= (TOP OF PIER ELEV.) - (PIER TIP ELEV.) **
* (GRADE LEVEL) - (2'-0") SEE DETAIL (S22)
** SEE THIS DRAWING

CONTOURS OF COMPETENT
ROCK & FINISHED GRADE
1/32" = 1'-0"

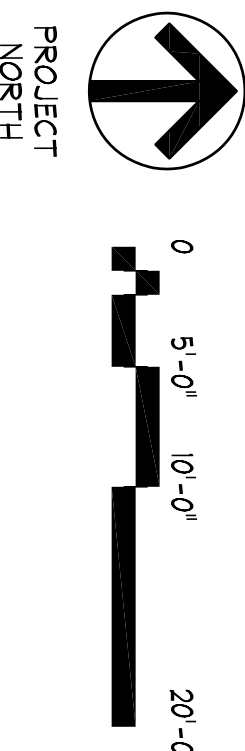

TITLE
CONTOUR
FOUNDATION
S1.0