
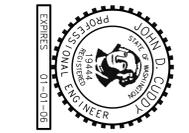


RENOVATION PLAN LEVEL 00 - SECTOR J  
1/8" = 1'-0"

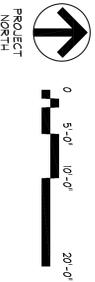


**INTEGRUS ARCHITECTURE**  
10 SOUTH CEDAR STREET  
SPOKANE WASHINGTON 99204  
509.838.8881 FAX 509.838.2194

**LMN ARCHITECTS**  
801 SECOND AVENUE SUITE 501  
SEATTLE WASHINGTON 98104  
206.682.3460 FAX 343.9388

CONSTRUCTION SET  
(REVISED - BID PACKAGE 6)

**SPOKANE CONVENTION CENTER EXPANSION**

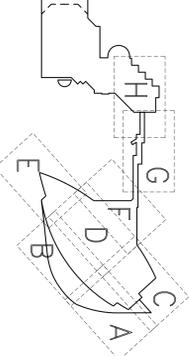

REVISIONS

NO.	DATE	BY	REVISION
1	10-20-04	BP-4	ADDITIONAL #1
2	10-28-04	BP-4	ADDITIONAL #2
3	11-04-04	BP-4	ADDITIONAL #3
4	01-21-05	BP-4	CLARIFICATION DWG
5	5-02-05	BP-5	
6	4-15-05	CDJ	015

RESPONSIBILITY

NO.	DATE	BY	REVISION
1	10-20-04	BP-4	ADDITIONAL #1
2	10-28-04	BP-4	ADDITIONAL #2
3	11-04-04	BP-4	ADDITIONAL #3
4	01-21-05	BP-4	CLARIFICATION DWG
5	5-02-05	BP-5	
6	4-15-05	CDJ	015

TITLE  
RENOVATION PLAN LEVEL 00  
SECTOR J  
**SXR 1.1-J**