


INTEGRUS ARCHITECTURE
 10 SOUTH CEDAR STREET
 SPOKANE WASHINGTON 99204
 509.838.8681 FAX 838.2194
 LMNARCHITECTS
 801 SECOND AVENUE SUITE 501
 SEATTLE WASHINGTON 98104
 206.682.3460 FAX 342.9388

CONSTRUCTION SET
(REVISED--BID PACKAGE 6)

SPokane CONVENTION CENTER EXPANSION

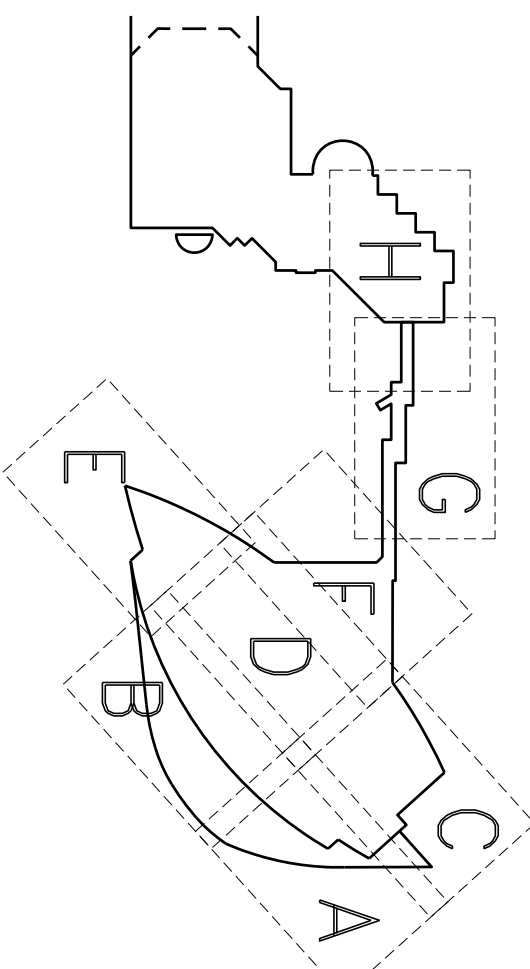

REVIEWS		
NO.	DATE	BY
5	10-20-04	BP-4 ADDENDUM #
6	10-28-04	BP-4 ADDENDUM #
7	11-04-04	BP-4 ADDENDUM #
8	01-21-05	BP-4 CLARIFICATION
9	5-07-05	BP-5
10	4-15-05	BP-6
		CDD 025

DESIGNED	
DRAWN	MA
CHECKED	JDC
DATE	4-15-05
CADD FILE	1508-1-02-j.dwg
JOB NUMBER	20150.00

TITLE
RENOVATION
PLAN LEVEL 01
SECTOR J

SXR 1.2-J

