


ISO\_1.fpbX.dwg

RENOVATION PLAN - LEVEL 00 - SECTOR 1  
1/8" = 1'-0"

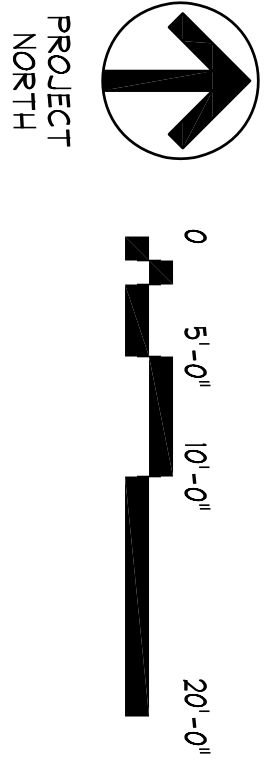

REVISIONS

NO.	DATE	BY	DESCRIPTION
1	10-20-04	BP	BP-4 ADDENDUM #1
2	10-28-04	BP	BP-4 ADDENDUM #2
3	11-04-04	BP	BP-4 ADDENDUM #3
4	01-21-05	BP	BP-4 CLARIFICATION DWG
5	3-02-05	BP	BP-5
6	4-15-05	CD	CD 015

DESIGNED	DRAWN	CHECKED	DATE	CADD FILE	JOB NUMBER
	MJA	JOC	4-15-05	ISO_1.1-00-1.dwg	20150.00

TITLE  
RENOVATION  
PLAN LEVEL 00  
SECTOR 1

SXR 1.1-1

INTEGRUS ARCHITECTURE

10 SOUTH CEDAR STREET  
SPOKANE WASHINGTON 99204  
509.838.8881 FAX 509.838.2194  
801 SECOND AVENUE SUITE 501  
SEATTLE WASHINGTON 98104  
206.682.3460 FAX 343.9388

LMNARCHITECTS

CONSTRUCTION SET  
(REVISED - BID PACKAGE 6)

SPOKANE  
CONVENTION CENTER  
EXPANSION

