


PARKING LEVEL 01 FOUNDATION
PARTIAL PLAN - SECTOR E
1/8" = 1'-0"

* CITY OF SPOKANE ACCEPTANCE
BY: _____
DATE: _____

* WSDOT ACCEPTANCE
BY: _____
DATE: _____

* THE ABOVE ACCEPTANCE IS ONLY FOR WORK WITHIN THE DIVISION STREET RIGHT OF WAY

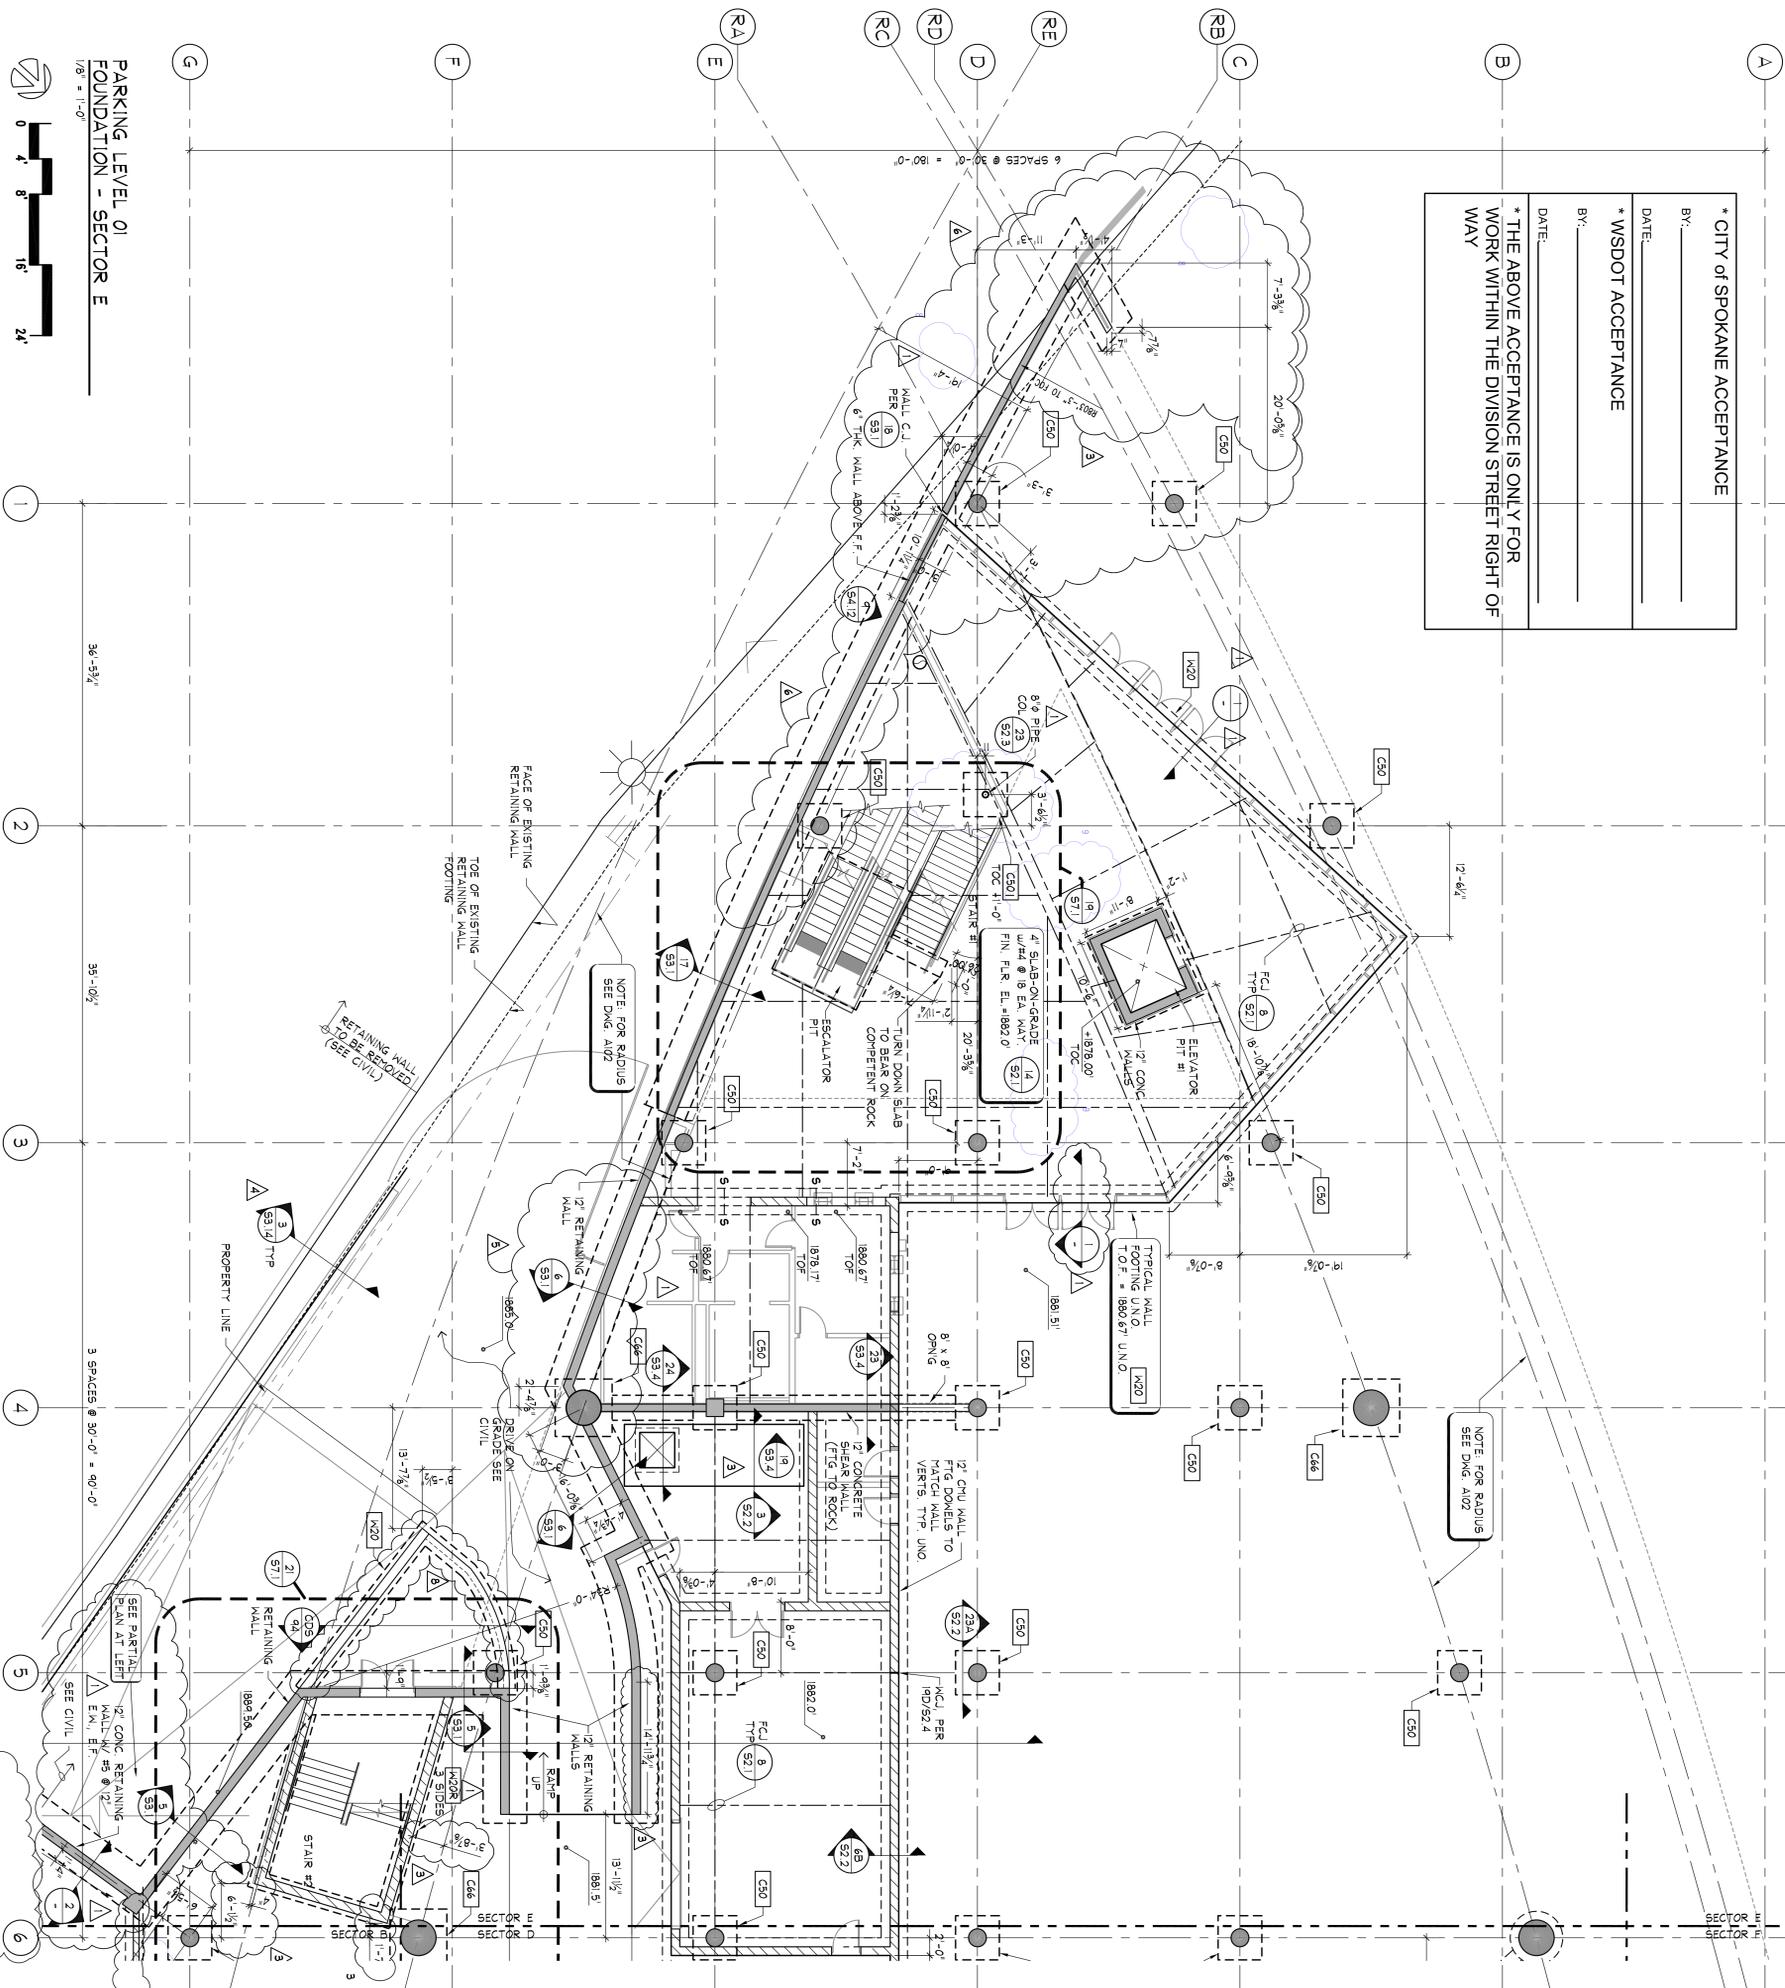

PARKING LEVEL 01
FOUNDATION - SECTOR E
1/8" = 1'-0"



REVISIONS

NO.	DATE	BY	REVISION
1	10-20-04	BR-1	ADD ADDENDUM #1
2	10-28-04	BR-1	ADD ADDENDUM #2
3	11-04-04	BR-1	ADD ADDENDUM #3
4	01-21-05	BR-1	CLARIFICATION DWG
5	3-07-05	BR-2	
6	4-15-05	CDI	025

DESIGNED: _____
DRAWN: F.A./H
CHECKED: JDC
DATE: 4-15-05
GRID FILE: 150A_L116-01E.dwg
JOB NUMBER: 20150.00


TITLE
PARKING LEVEL 01
FOUNDATION
SECTOR E
S1.1E

INTEGRUS ARCHITECTURE
10 SOUTH CEDAR STREET
SPOKANE WASHINGTON 99204
509.838.8881 FAX 509.838.2194

LMN ARCHITECTS
801 SECOND AVENUE SUITE 501
SEATTLE WASHINGTON 98104
206.682.3460 FAX 343.5388

CONSTRUCTION SET
(REVISED - BID PACKAGE 6)

SPOKANE CONVENTION CENTER EXPANSION

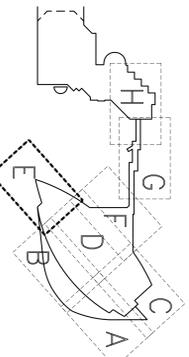

REVISIONS

NO.	DATE	BY	REVISION
1	10-20-04	BR-1	ADD ADDENDUM #1
2	10-28-04	BR-1	ADD ADDENDUM #2
3	11-04-04	BR-1	ADD ADDENDUM #3
4	01-21-05	BR-1	CLARIFICATION DWG
5	3-07-05	BR-2	
6	4-15-05	CDI	025

DESIGNED: _____
DRAWN: F.A./H
CHECKED: JDC
DATE: 4-15-05
GRID FILE: 150A_L116-01E.dwg
JOB NUMBER: 20150.00

TITLE
PARKING LEVEL 01
FOUNDATION
SECTOR E
S1.1E