


INTEGRUS ARCHITECTURE
 10 SOUTH CEDAR STREET
 SPOKANE WASHINGTON 99204
 509.838.8881 FAX 509.838.7194
LMNARCHITECTS
 801 SECOND AVENUE SUITE 501
 SEATTLE WASHINGTON 98104
 206.682.3460 FAX 343.5388

CONSTRUCTION SET
 (REVISED - BID PACKAGE 6)

SPOKANE CONVENTION CENTER EXPANSION

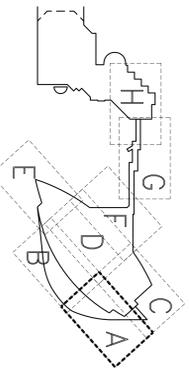


REVISIONS

NO.	DATE	BY	REVISION
1	10-20-04	BR-1	ADDITIONAL #1
2	10-28-04	BR-1	ADDITIONAL #2
3	11-04-04	BR-1	ADDITIONAL #3
4	01-21-05	BR-1	CLARIFICATION DWG
5	3-07-05	BR-1	
6	4-15-05	CDI	025

DESIGNED	DRAWN	CHECKED	DATE	GRID FILE	JOB NUMBER
	T.A./H.H.	JDC	4-15-05	150A_L1-01A.dwg	201501.00

TITLE
PARKING LEVEL 01 FOUNDATION - SECTOR A
S1.1A

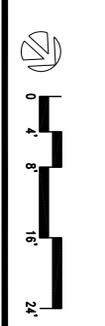

* CITY OF SPOKANE ACCEPTANCE
 BY: _____
 DATE: _____

* WSDOT ACCEPTANCE
 BY: _____
 DATE: _____

* THE ABOVE ACCEPTANCE IS ONLY FOR WORK WITHIN THE DIVISION STREET RIGHT OF WAY

PARKING LEVEL 01
 FOUNDATION - SECTOR A