


ISO_n_fpr.dwg

RENOVATION PLAN - LEVEL 01 - SECTOR 1
1/8" = 1'-0"


PROJECT NORTH
0 5'-0" 10'-0" 20'-0"

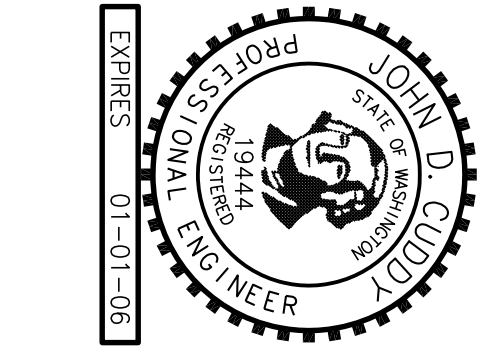

INTEGRUS ARCHITECTURE
10 SOUTH CEDAR STREET
SPOKANE WASHINGTON 99204
509.838.8881 FAX 509.838.2194
LMNARCHITECTS
801 SECOND AVENUE SUITE 501
SEATTLE WASHINGTON 98104
206.682.3460 FAX 343.9388

CONSTRUCTION SET
(REVISED - BID PACKAGE 6)

SPOKANE
CONVENTION CENTER
EXPANSION

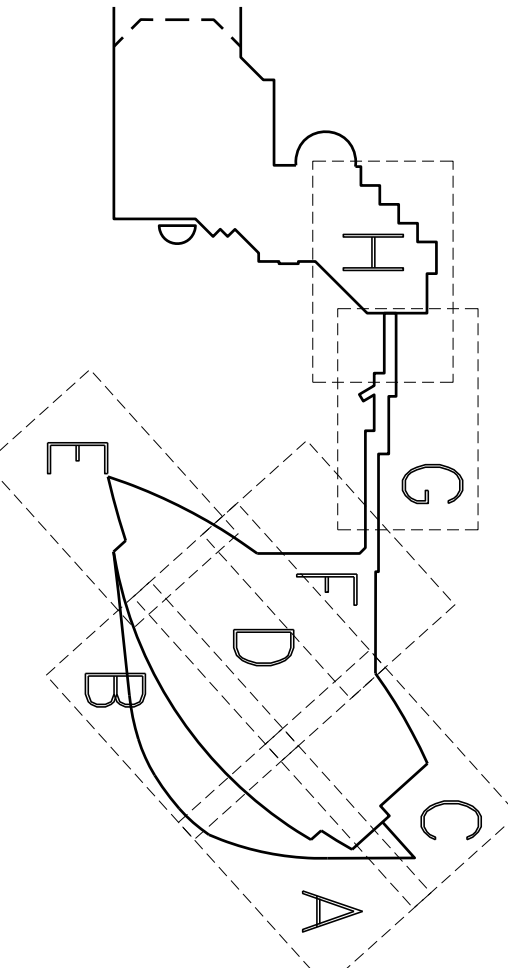

NO.	DATE	BY	DESCRIPTION
1	10-20-04	BP-4	ADDENDUM #1
2	10-28-04	BP-4	ADDENDUM #2
3	11-04-04	BP-4	ADDENDUM #3
4	01-21-05	BP-4	CLARIFICATION DWG
5	3-02-05	BP-5	
6	4-15-05	CD 015	

DESIGNED	DRAWN	CHECKED	DATE	CADD FILE	JOB NUMBER
MJA	MJA	JOC	4-15-05	ISO_n_1-02-1.dwg	20150.00

TITLE
RENOVATION
PLAN LEVEL 01
SECTOR 1
SXR 1.2-1